

BARNSLEY METROPOLITAN BOROUGH COUNCIL

HIGHWAYS ACT 1980

**THE METROPOLITAN BOROUGH OF BARNSLEY
(PUBLIC FOOTPATHS 14 & 57 WOMBWELL)
PUBLIC PATHS CREATION ORDER 2019**

The foregoing order is hereby confirmed
subject to the red ink modifications thereon

Julia Evans

An Inspector appointed by The Secretary
of State for Environment, Food and
Rural Affairs

4 OCT 2022

A.C. Frosdick, LL.B. DipLG,
Executive Director of Core
Services & Solicitor to the Council,
Town Hall,
Barnsley.

BARNSELY METROPOLITAN BOROUGH COUNCIL

HIGHWAYS ACT 1980

**THE METROPOLITAN BOROUGH OF BARNSELY
(PUBLIC FOOTPATHS 14 & 57 WOMBWELL)
PUBLIC PATHS CREATION ORDER 2019**

THIS ORDER is made by Barnsley Metropolitan Borough Council ("the authority") under Section 26 of the Highways Act 1980 ("the 1980 Act") because it appears to the authority that, having regard to the matters set out in Section 26(1), there is a need for public footpaths over the land to which this Order relates, and that it is expedient that the paths should be created.

BY THIS ORDER:-

1. There shall be at the end of 7 days from the date of confirmation of this Order public footpaths over the land situate at Broomhill Wombwell Barnsley described in the Schedule to this Order and shown by bold broken lines on the map attached to this Order.
2. THIS Order may be cited as the Metropolitan Borough of Barnsley (Public Footpaths 14 & 57 Wombwell) Public Path Creation Order 2019.

SCHEDULE

Description of Land

A public footpath having a width of 4.0 metres throughout which commences at Highgate at grid reference 4194/0246 and proceeds generally south ~~west~~ for a distance of 55 metres to join Wombwell public footpath no. 14 at grid reference 4193/0241, as shown between the points marked A B and C on the attached map.


A public footpath having a width of 1.5 metres throughout which commences at A6195 to the south west of Broomhill roundabout at grid reference 4194/0235 and proceeds ~~generally~~ firstly south east then south for a distance of 120 metres to join Wombwell public bridleway no. 51 at grid reference 4195/0224, as shown between the points marked ~~H~~ G and I on the attached map.

THE COMMON SEAL of)
Barnsley Metropolitan Borough)
Council was hereunto affixed)
the 3rd day of September)
Two thousand and nineteen)
in the presence of:- *al*)



1660
IN REGISTER

Executive Director of Core Services & Solicitor to the Council/Authorised Signatory
(Part 1 Para 4(h) Delegations to Highways & Engineering from PRB Officer decision 29.8.2019)

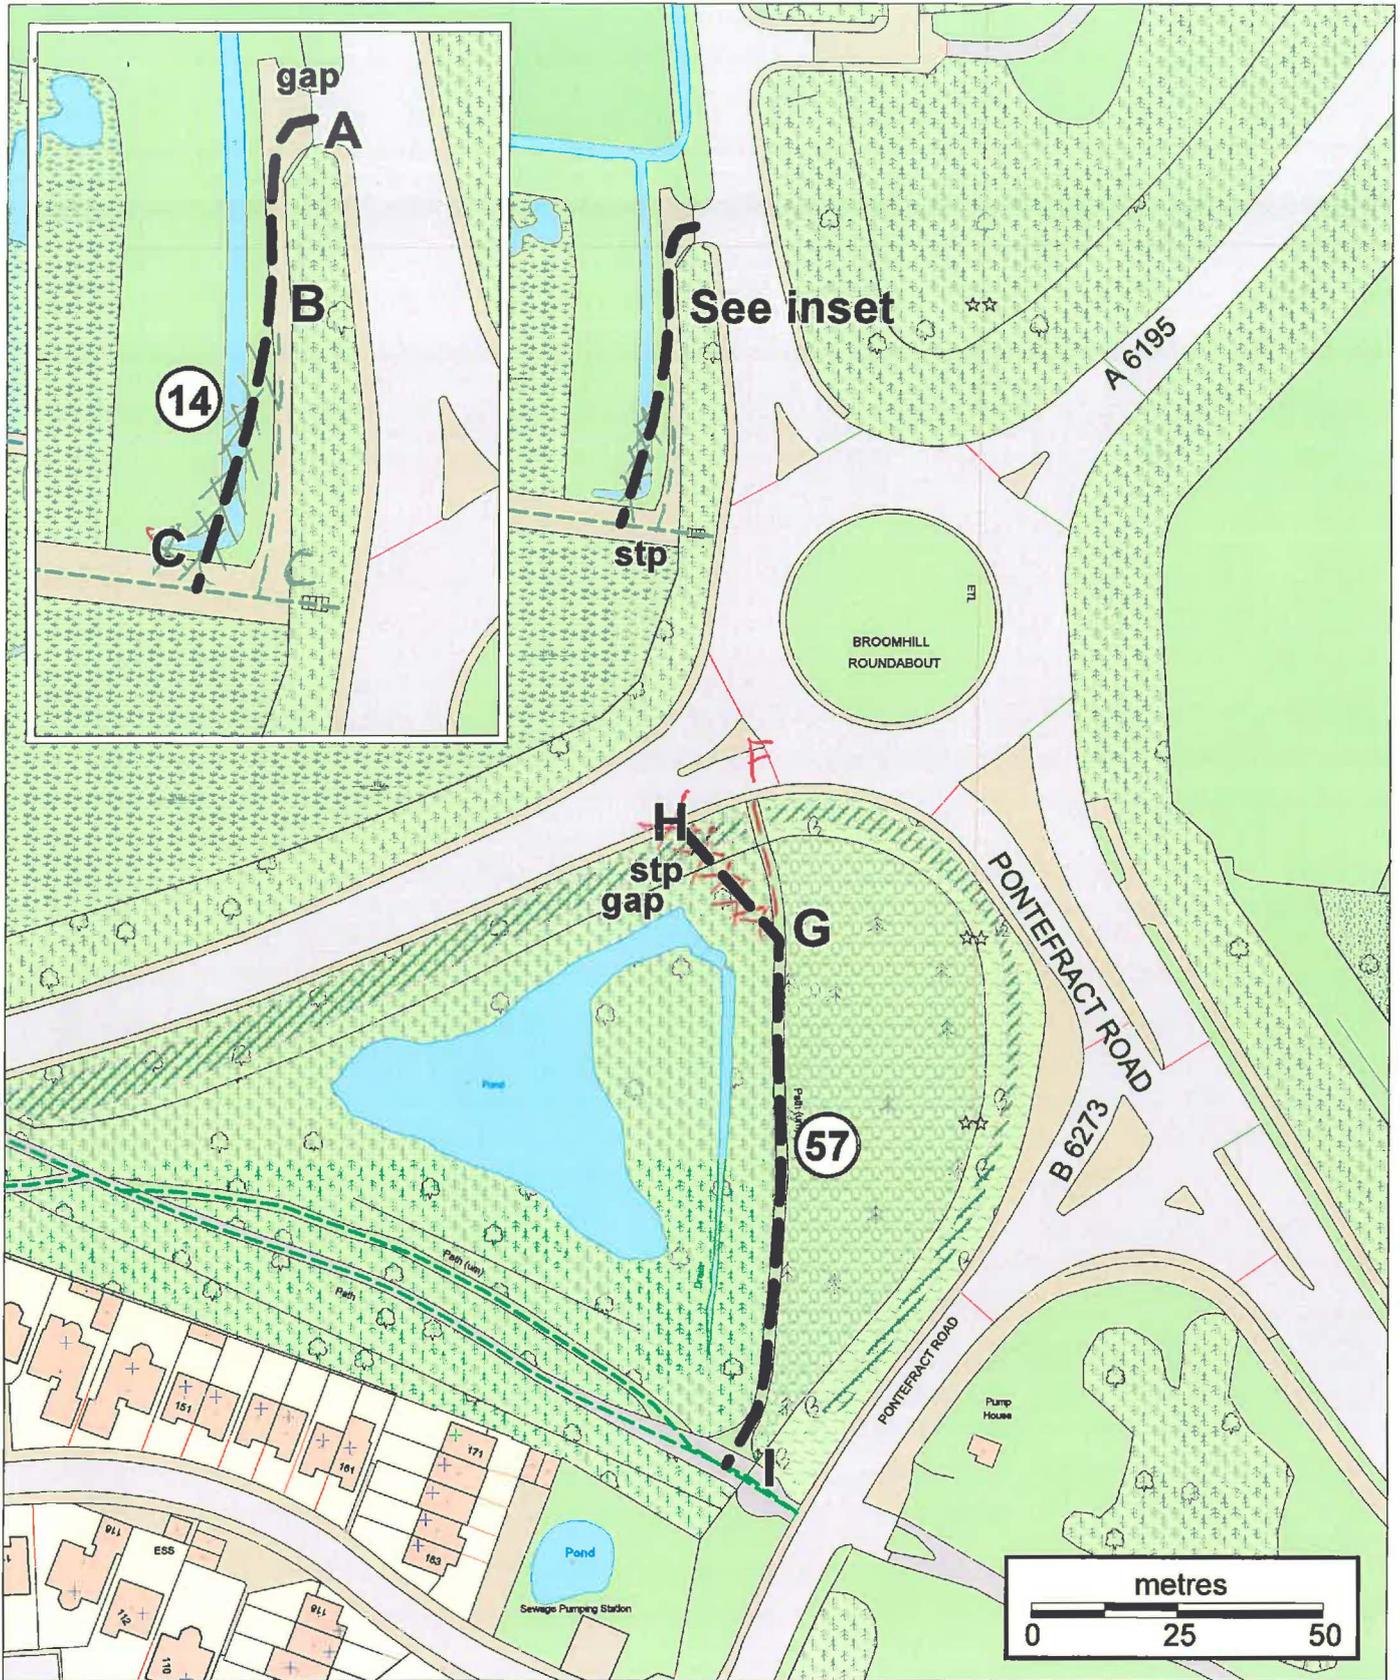

The Metropolitan Borough of Barnsley
 Public footpath nos. 14 & 57 Wombwell
 Public Path Creation Order 2019

Drawn by BMBC	Scale 1 : 1250
-	-

Footpaths to be created
 — — — — —
 Unaffected rights of way
 - - - - -

