

BARNSELY METROPOLITAN BOROUGH COUNCIL

HIGHWAYS ACT 1980

**THE METROPOLITAN BOROUGH OF BARNSELY
(PUBLIC FOOTPATH NO 14 & UNDEFINED PATHS) (WOMBWELL)
PUBLIC PATH EXTINGUISHMENT ORDER 2019**

The foregoing order is hereby confirmed
subject to the red ink modifications thereon

Julia Evans

An Inspector appointed by The Secretary
of State for Environment, Food and
Rural Affairs

4 OCT 2022

A.C. Frosdick, LL.B. DipLG,
Executive Director of Core
Services & Solicitor to the
Council,
Town Hall,
Barnsley.

BARNSELY METROPOLITAN BOROUGH COUNCIL

HIGHWAYS ACT 1980

**THE METROPOLITAN BOROUGH OF BARNSELY
(PUBLIC FOOTPATH NO 14 & UNDEFINED PATHS) (WOMBWELL)
PUBLIC PATH EXTINGUISHMENT ORDER 2019**

THIS ORDER is made by Barnsley Metropolitan Borough Council ("the authority") under Section 118 of the Highways Act 1980 ("the 1980 Act") because it appears to the authority that the footpaths described in paragraph 1 below are not needed for public use.

BY THIS ORDER:-

1. The public rights of way over the land situate to the north west and south sides of Broomhill Roundabout at Wombwell Barnsley shown by continuous bold lines on the map contained in this Order and described in the Schedule to this Order shall be extinguished after 7 days from the date of confirmation of this Order.
2. THIS Order may be cited as the Metropolitan Borough of Barnsley (Public Footpath No. 14 & Undefined Paths) (Wombwell) Public Path Extinguishment Order 2019.


SCHEDULE

Footpaths to be Extinguished

The full width of part of public footpath no. 14 Wombwell which commences on the western boundary of Broomhill roundabout at grid reference 4195/0240 and proceeds west for a distance of 9 metres to grid reference 4194/0240, as shown between the points marked E and D on the attached map.

The full width of an undefined footpath which commences at a point 9 metres west of the western boundary of Broomhill roundabout at grid reference 4194/0240 and proceeds north along an access track for a distance of 35 metres to grid reference 4194/0244, as shown between the points marked D and B on the attached map.

~~The full width of an undefined footpath which commences at the A6195 at the southern side of Broomhill roundabout at grid reference 4195/0236 and proceeds south for a distance of 25 metres to grid reference 4196/0233, as shown between the points marked F and G on the attached map.~~

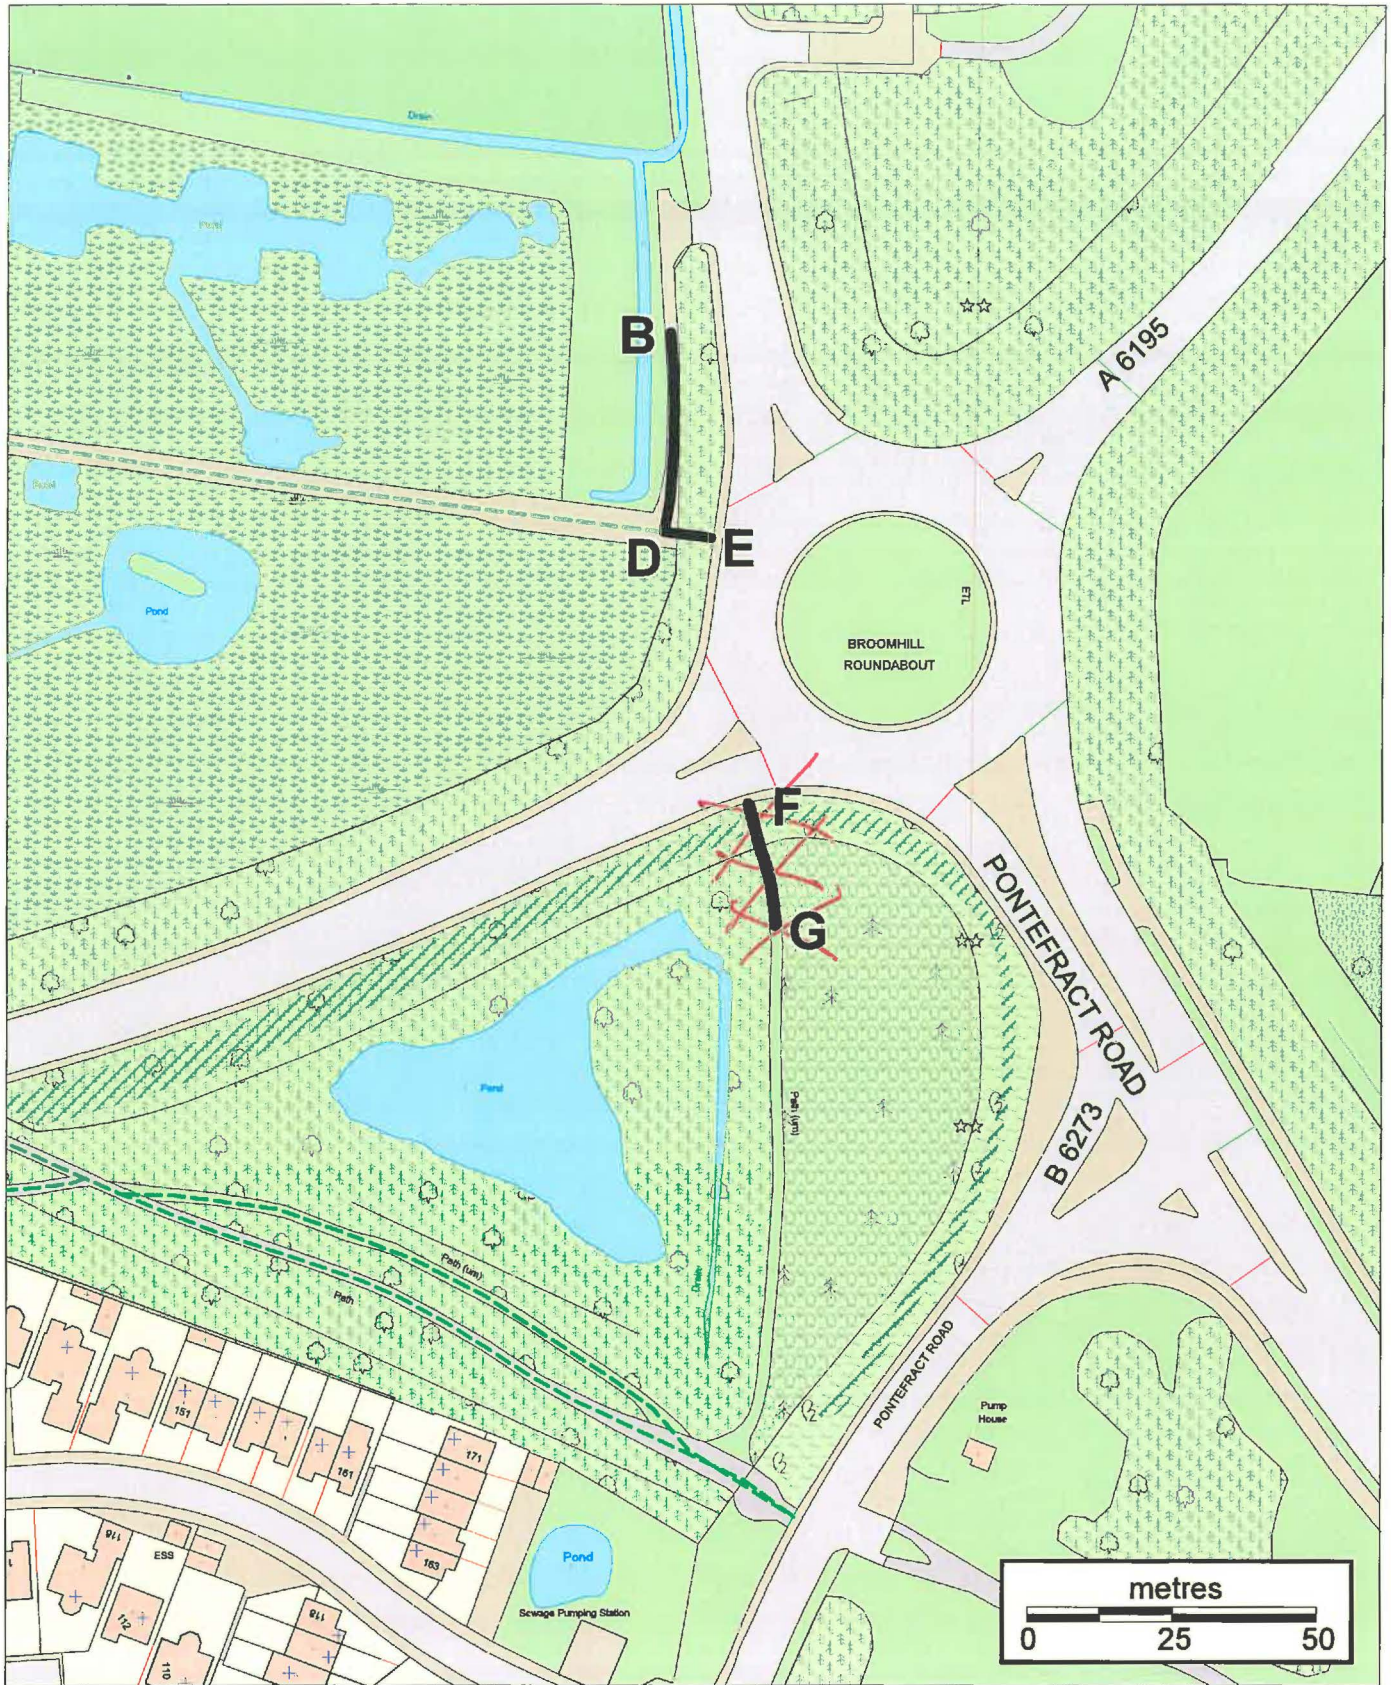

The Metropolitan Borough of Barnsley
 Public footpath no. 14 Wombwell
 & unrecorded footpaths
 Public Path Extinguishment Order 2019

Drawn by BMBC	Scale 1 : 1250
-	-

Footpaths to be extinguished
 —————
 Unaffected rights of way
 - - - - -



THE COMMON SEAL of)
Barnsley Metropolitan Borough)
Council was hereunto affixed)
the 3rd day of September)
Two thousand and ~~eighteen~~ nineteen)
in the presence of:- *a*)



Executive Director of Core Services & Solicitor to the Council/Authorised signatory
(Part 1 Para 4(h) Delegations to Highways & Engineering from PRB Officer decision 29.8.2019)

